

SUBMITTAL RECORD

Norcross, GA — Lidl #1517 | Job 15170000GR
4990 Jimmy Carter Blvd, Norcross, GA 30093



Submittal Information

PSI Log #	SUB-009 (Rev 0)	Procore #	1-2.0 — Mast Arm Pole Shop Drawings #1, #2, #3
Fieldwire #	PSI-0006 — Shop Drawings for the Mast Arm Poles	Type	Shop Drawing
Spec Section	None assigned — Procore "1 - Default Section"	Status	Pending — no response. OVERDUE (Fieldwire response due 09/25/2026)
Subcontractor	R.J. Haynie & Associates (ship-to); sold to DOT Lighting, LLC; agent Traffic & Lighting Corp; manufacturer Valmont Industries (Valley, NE)	Submitted By	Tucker Teague (Place Services Inc.) — PSI stamp No Exception Taken 9/18/2026 (all 3 sheets)
Scope / Location	Off-site traffic signal structures: Gwinnett County TS-082, Jimmy Carter Blvd @ Shelby Dr	Ball in Court	Christopher Manes (CHA Consulting, Inc.)
Issue Date	Sep 18, 2026	Final Due Date	None set in Procore
Procore Received	Sep 25, 2026	Description	Place Services Inc. - No Exceptions Taken
Distribution	Christopher Manes, JaWanna English-Neal, Jeff Belyea, Todd Seldomridge (CHA Consulting); Jens Byer (Lidl US); Bobby McTeague, Luis Marcelino, Tucker Teague (Place Services Inc.)		

Package Contents

Dwg #1	Valmont GA672263P1 sheet 1 of 2 (order 672263-P1, drawn/checked NKL 08/25/26) — details, material data, AASHTO 2015 LRFD SLTS-1 design basis (115 mph). Sealed: Nizam A Qassem, GA PE039283, digitally signed 2026-08-31
Dwg #2	Valmont GA672263P1 sheet 2 of 2 — pole & signal arm data: Pole B 16"/12.92" x 22' tube, arms 65' + 55'; Pole C 16"/11.80" x 30' tube, arms 55' + 55'; (4) 2.25" x 89" anchor bolts each; radial index
Dwg #3	Hand sketch — pole/arm orientation at TS-082 (Pole C anchor bolts in line with 55' mast arm; Pole B 65'/55' arms)

Submittal Workflow / Revision History

Rev	Name	Sent	Due	Returned	Response	Attachment
0	Christopher Manes (CHA Consulting)	Sep 18, 2026	Sep 25, 2026*	—	None — OVERDUE 6 days	#1517 Lidl Norcross, GA - Mast Arm Pole Shop Drawings #1,#2,#3.pdf

* No Final Due Date in Procore; due date taken from Fieldwire PSI-0006 "Response due 09/25/2026".

Reviewer Comments / Notes

No engineer review stamp or markups as of Oct 1, 2026.

Note: "Pole Foundations — 3'-0" Dia x 14'-6" Deep - (8) #10 Rebar" (Poles B & C) on Dwg #2 is an unsigned text annotation added to the PDF, not part of Valmont's sealed drawing. Verify foundation design against the signal plans / county standard before drilling.

Off-site traffic signal structures may also require Gwinnett County DOT acceptance — confirm review path with CHA.

Enclosed (merged behind this sheet, unaltered)

Full Procore export as received Oct 1, 2026 — 5 pages: p1 Procore cover; p2 Fieldwire PSI-0006 cover; p3–4 Valmont shop drawings (11x17); p5 orientation sketch.

Prepared by Luis Marcelino, Place Services, Inc. — Oct 1, 2026



Lidl US, LLC
3500 S. Clark St.
Arlington , Virginia 22202
P: (571) 398-5435

Project: 1517 Norcross GA - Jimmy Carter Blvd
4990 Jimmy Carter Blvd
Norcross, Georgia 30093

Submittal #1-2.0 - Mast Arm Pole Shop Drawings #1,#2,#3 1 - Default Section

Revision	0	Submittal Manager	Christopher Manes (21327198 CHA Consulting, INC.)
Status	Open	Date Created	Sep 18, 2026
Issue Date	Sep 18, 2026	Spec Section	1 - Default Section
Responsible Contractor	Place Services Inc.	Received From	Tucker Teague (Place Services Inc.)
Received Date	Sep 25, 2026	Submit By	Sep 18, 2026
Final Due Date		Lead Time	
		Cost Code	
Location		Type	Shop Drawing
Submittal Package			
Approvers			
Ball in Court	Christopher Manes (21327198 CHA Consulting, INC.)		
Distribution	Bobby McTeague (Place Services Inc.), Christopher Manes (21327198 CHA Consulting, INC.), JaWanna English-Neal (21327198 CHA Consulting, INC.), Jeff Belyea (21327198 CHA Consulting, INC.), Jens Byer (28101155 Lidl US, LLC), Luis Marcelino (Place Services Inc.), Todd Seldomridge (21327198 CHA Consulting, INC.), Tucker Teague (Place Services Inc.)		
Description	Place Services Inc. - No Exceptions Taken		

Submittal Workflow

Name	Sent Date	Due Date	Returned Date	Response	Attachments
General Information Attachments					#1517 Lidl Norcross, GA - Mast Arm Pole Shop Drawings #1,#2,#3.pdf

Lidl 1517 Norcross, GA - Ground Up

4990 Jimmy Carter Blvd. Norcorss, GA 30093

Report generated by Tucker Teague (Place Services, Inc.)



Submittal #PSI-0006 - Shop Drawings for the Mast Arm Poles


Creator	Tucker Teague (Place Services, Inc.)	Submission due	-
Assignee	Tucker Teague (Place Services, Inc.)	Response due	09/25/2026
Reviewers	-	Closed on	-
Status	Pending approval	Reference number	-
Type	Shop drawings	Specification	-
Description	-		

Approval (rev. 0)

Responded by	-	Responded on	-
Response	-		
Notes	-		
Attachments	-		

Submission (rev. 0)

Submitted by	Tucker Teague (Place Services, Inc.)	Submitted on	09/18/2026
Notes	Place Services Inc. - No Exceptions Taken		
Attachments	PDF attachments are included in this export. ↓ Mast Arm Pole Shop Drawings #1.pdf (Page 2)) ↓ Mast Arm Pole Shop Drawings #2.pdf (Page 3)) ↓ Mast Arm Pole Shop Drawings #3.pdf (Page 4))		


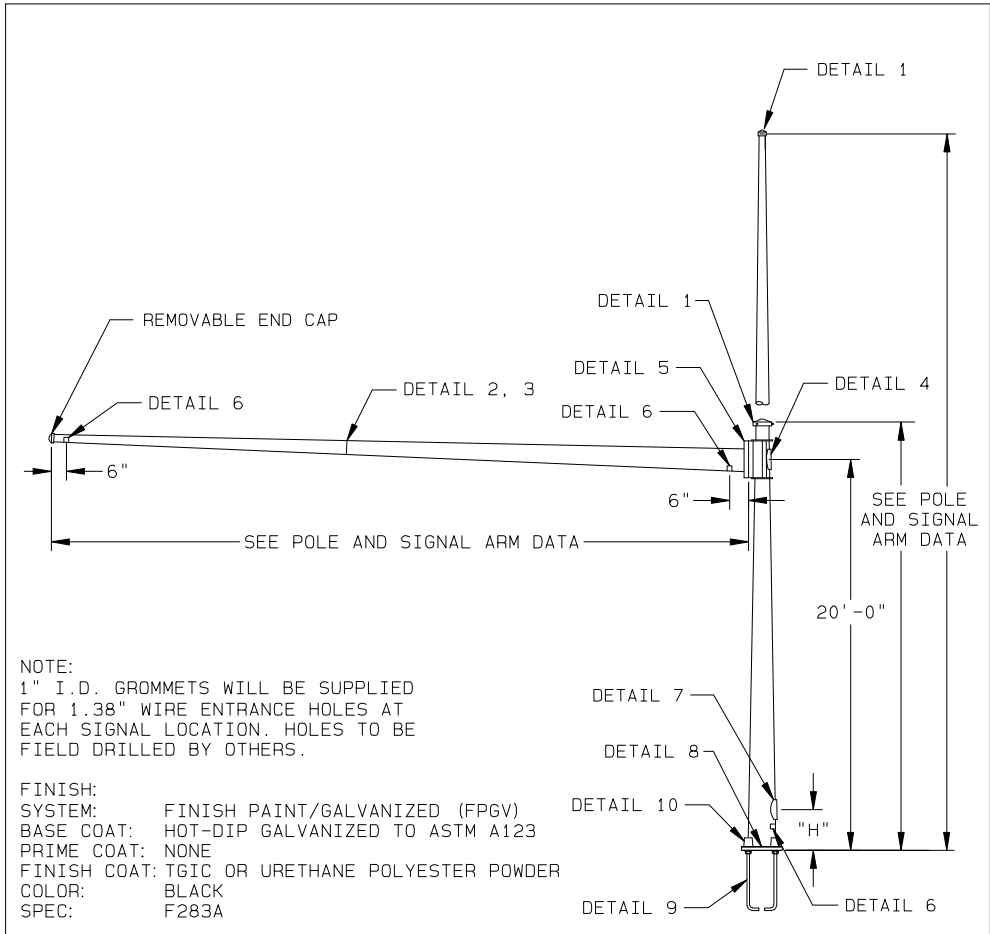


MATERIAL DATA					
COMPONENT	ASTM DESIGNATION	MIN. YIELD (KSI)	COMPONENT	ASTM DESIGNATION	MIN. YIELD (KSI)
TAPERED TUBES	A595 GR. A OR A572	55	BASE PLATE	A36	36
ANCHOR BOLTS	F1554 GR.55	55	SIGNAL ARM ATTACHMENT	A36	36
NUTS AND BOLTS	A563, F436		SIG. ARM CONN. BOLTS	A325	
HARDWARE COATING	HOT DIP ZINC				
HARDWARE $\leq$ 0.50" IS STAINLESS STEEL					




THE MAST ARM TRAFFIC STRUCTURES SHOWN ON THIS DRAWING HAVE BEEN DESIGNED IN ACCORDANCE WITH THE LOADING AND THE NOMINAL STRENGTH REQUIREMENTS OF THE 2015 AASHTO LRFD SPECIFICATIONS FOR STRUCTURAL SUPPORTS FOR HIGHWAY SIGNS, LUMINAIRES AND TRAFFIC SIGNALS, FIRST EDITION" SLTS-1. THE WIND LOADS WERE CALCULATED FROM AN ULTIMATE WIND VELOCITY OF 115 MPH WITH A MEAN RECURRENCE INTERVAL OF 700 YEARS, AND A FATIGUE CATEGORY OF 2. THE FATIGUE LOADS WERE CALCULATED ON THE REQUIREMENTS OF SECTION 11 OF THE CODE, AND THE FOLLOWING DESIGN CONDITIONS:

- STRUCTURES ARE DESIGNED TO RESIST NATURAL WIND GUSTS BASED ON THE YEARLY MEAN WIND VELOCITY OF 11.2 MPH.
- STRUCTURES ARE NOT DESIGNED TO RESIST GALLOPING-INDUCED CYCLIC LOADS.
- TRUCK-INDUCED GUST LOADS ARE NOT INCLUDED PER THE REQUIREMENTS OF THE CODE.

AASHTO 2015 SPECIFICATIONS


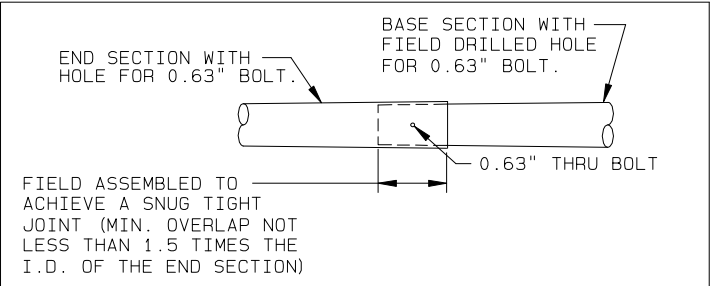
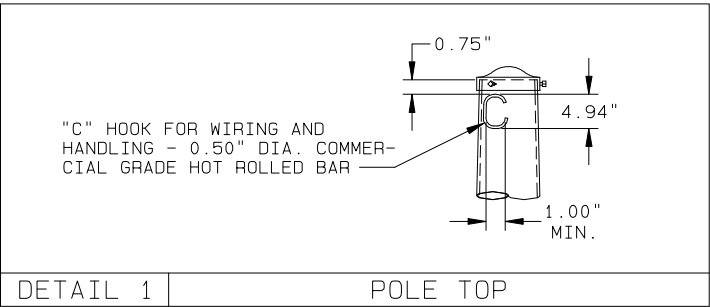


POLE	SPAN (FT)	BASE SECTION		END SECTION		
		LENGTH (FT)	GAUGE OR THK. (IN)	LARGE END O.D. (IN)	LENGTH (FT)	GAUGE OR THK. (IN)
B	65.00	19.54	0.313	13.00	48.15	7
	55.00	23.00	0.250	12.00	34.58	7
C	55.00	23.00	0.250	12.00	34.58	7
	55.00	23.00	0.250	12.00	34.58	7

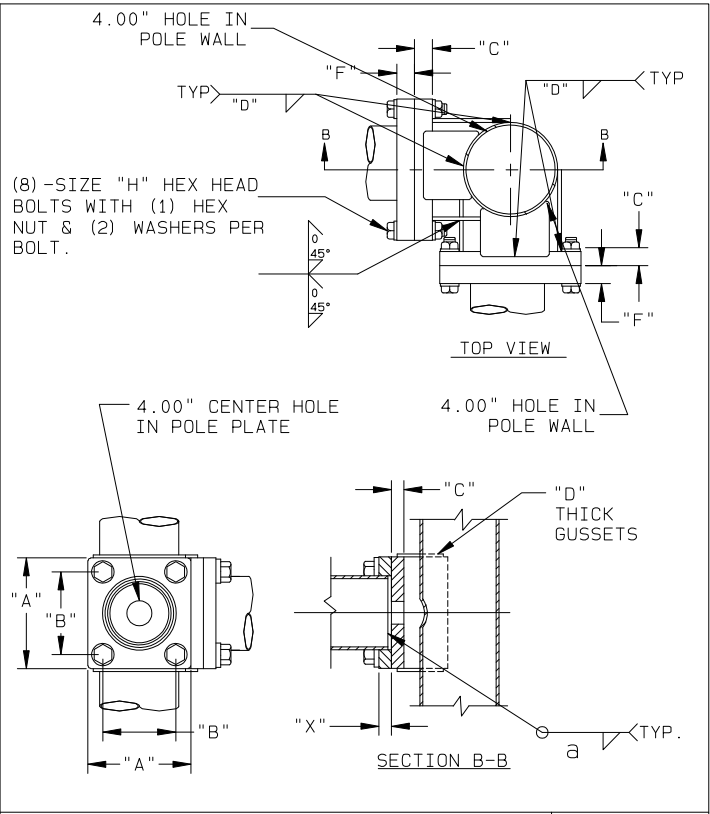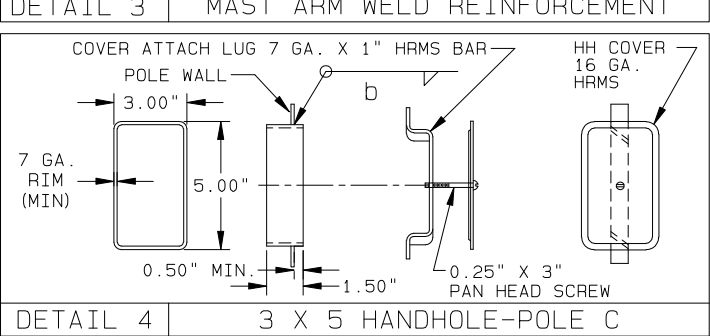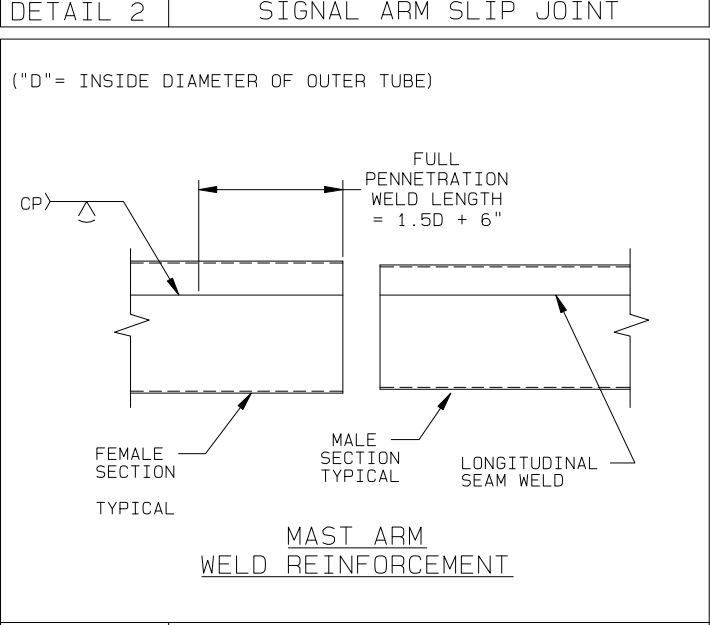

ARM-TO-PLATE WELD "E"	BEVEL "F"X"G"
(ARM THK.+ .25") X ARM THK.	.19" X 30°

SIGNAL ARM ATTACHMENT DATA						
POLE	"A" (IN)	"B" (IN)	POLE PLATE "C" (IN)	ARM PLATE "X" (IN)	"D" (IN)	"H" (IN)
B	24.00	19.00	2.00	3.00	0.500	1.25 X 7.00
C	24.00	19.00	2.00	3.00	0.500	1.25 X 7.00

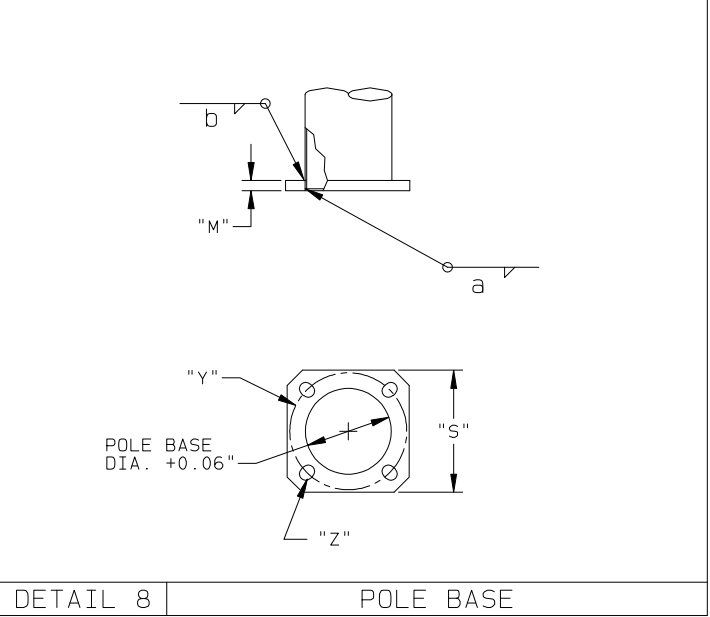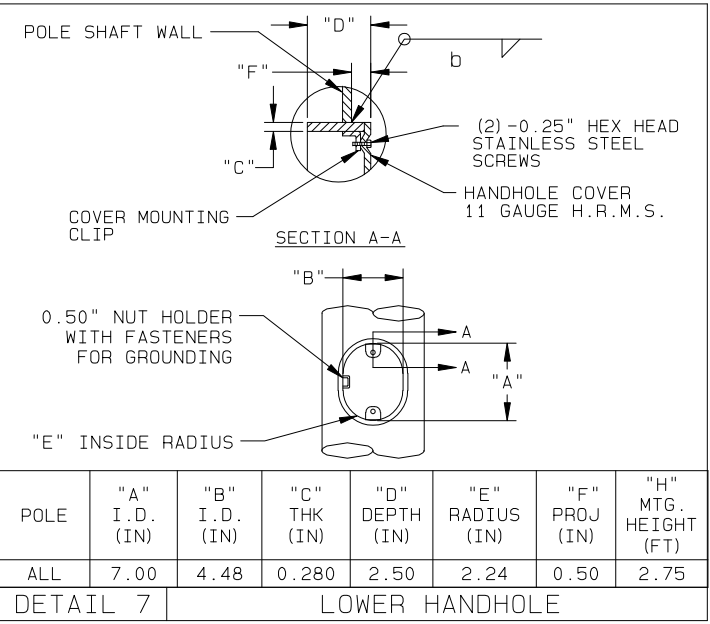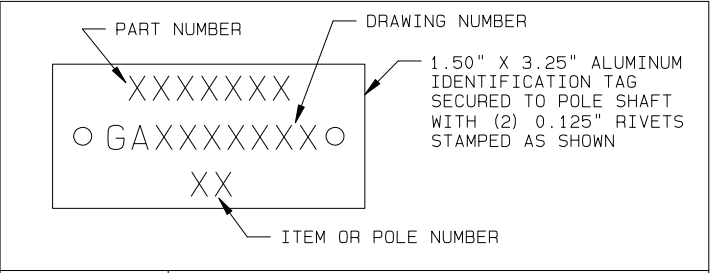

SHOP DRAWING / SUBMITTAL REVIEW

☒ NO EXCEPTION TAKEN
☐ REVISE AND RESUBMIT
☐ MAKE CORRECTIONS NOTED
☐ REJECTED

SUBMITTAL WAS REVIEWED FOR DESIGN CONFORMANCE AND GENERAL CONFORMANCE TO CONTRACT DOCUMENTS ONLY. THE CONTRACTOR IS RESPONSIBLE FOR CONFIRMING AND CORRELATING DIMENSIONS AT JOBSITE FOR TOLERANCE, CLEARANCE, QUANTITIES, FABRICATION PROCESSES AND TECHNIQUES OF CONSTRUCTION. COORDINATION OF HIS WORK WITH OTHER TRADES AND FULL COMPLIANCE WITH CONTRACT DOCUMENTS.

By: **Tucker Teague**
Date: **9/18/2026**

Place Services, Inc
Canton, GA 30115


GEORGIA REGISTERED
No. PE039283
PROFESSIONAL
ENGINEER
NIZAM A QASSEM

Digitally signed by
Nizam A Qassem
Date: 2026-08-31
16:11-05:00

				SOLD TO: DOT LIGHTING, LLC	JOB	WINNETT COUNTY, GEORGIA	VALMONT INDUSTRIES, INC. RESERVES THE RIGHT TO INSTALL VARIOUS. ENGINEER APPROVED, MATERIAL HANGING ACCOMMODATIONS TO FACILITATE THE MANUFACTURING PROCESS.	ORDER NUMBER: 672263-P1
				SHIP TO: R.J. HAYNIE AND ASSOCIATES		JIMMY CARTER BLVD/SHELBY DR		PAGE NUMBER: 1 OF 2
				P.O. #: 2023				DRAWING NUMBER
				AGENT: TRAFFIC & LIGHTING CORP	TITLE	TRAFFIC SIGNAL STRUCTURES		GA672263P1
NKL 08/25/26	NKL 08/25/26							REV
REV	DRAWN BY-DATE	CHECK BY-DATE						


[illegible]

3'-0" Dia x 14'-6" Deep - (8) #10 Rebar

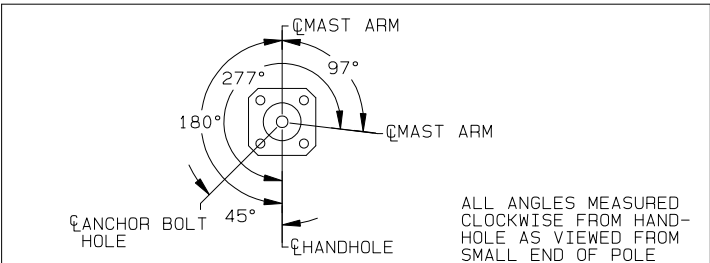

POLE C - RADIAL INDEX

WELD SIZE TABLE						
TUBE THICKNESS	a		b		c	
11 GA (0.1196")	.12	7/64"	.19	3/16"	.31	5/16"
7 GA (0.1793")	.18	11/64"	.25	1/4"	.44	7/16"
5 GA (0.2092")	.21	13/64"	.31	5/16"	.56	9/16"
3 GA (0.2391")	.24	15/64"	.31	5/16"	.56	9/16"
0.219"	.22	7/32"	.31	5/16"	.56	9/16"
0.250"	.25	1/4"	.31	5/16"	.56	9/16"
0.313"	.31	5/16"	.38	3/8"	.69	11/16"

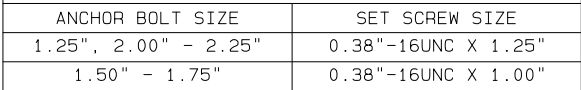

JOB	GWINNETT COUNTY, GEORGIA JIMMY CARTER BLVD/SHELBY DR
TITLE	TRAFFIC SIGNAL STRUCTURES

valmont 
Valley, NE 68064
(402) 359-2201

ORDER NUMBER: 672263-P1	
PAGE NUMBER: 2	OF 2
DRAWING NUMBER	REV
GA672263P1	

T.S. #082

Jimmy Carter Blvd

Shelby Dr.

Gwinnett Co.

Anchor bolts in line
with this mast arm




SS'

Jimmy Carter Blvd

SS'

65'

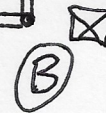

Shelby Dr

**SHOP DRAWING /
SUBMITTAL REVIEW**

- ☒ NO EXCEPTION TAKEN
- ☐ REVISE AND RESUBMIT
- ☐ MAKE CORRECTIONS NOTED
- ☐ REJECTED

SUBMITTAL WAS REVIEWED FOR DESIGN
CONFORMITY AND GENERAL CONFORMANCE TO
CONTRACT DOCUMENTS ONLY. THE CONTRACTOR IS
RESPONSIBLE FOR CONFIRMING AND CORRELATING
DIMENSIONS AT JOBSITE FOR TOLERANCE,
CLEARANCE, QUANTITIES, FABRICATION PROCESSES
AND TECHNIQUES OF CONSTRUCTION,
COORDINATION OF HIS WORK WITH OTHER TRADES
AND FULL COMPLIANCE WITH CONTRACT
DOCUMENTS.

By: Tucker Teague

Date: 9/18/2026

Place Services, Inc
Canton, GA 30115